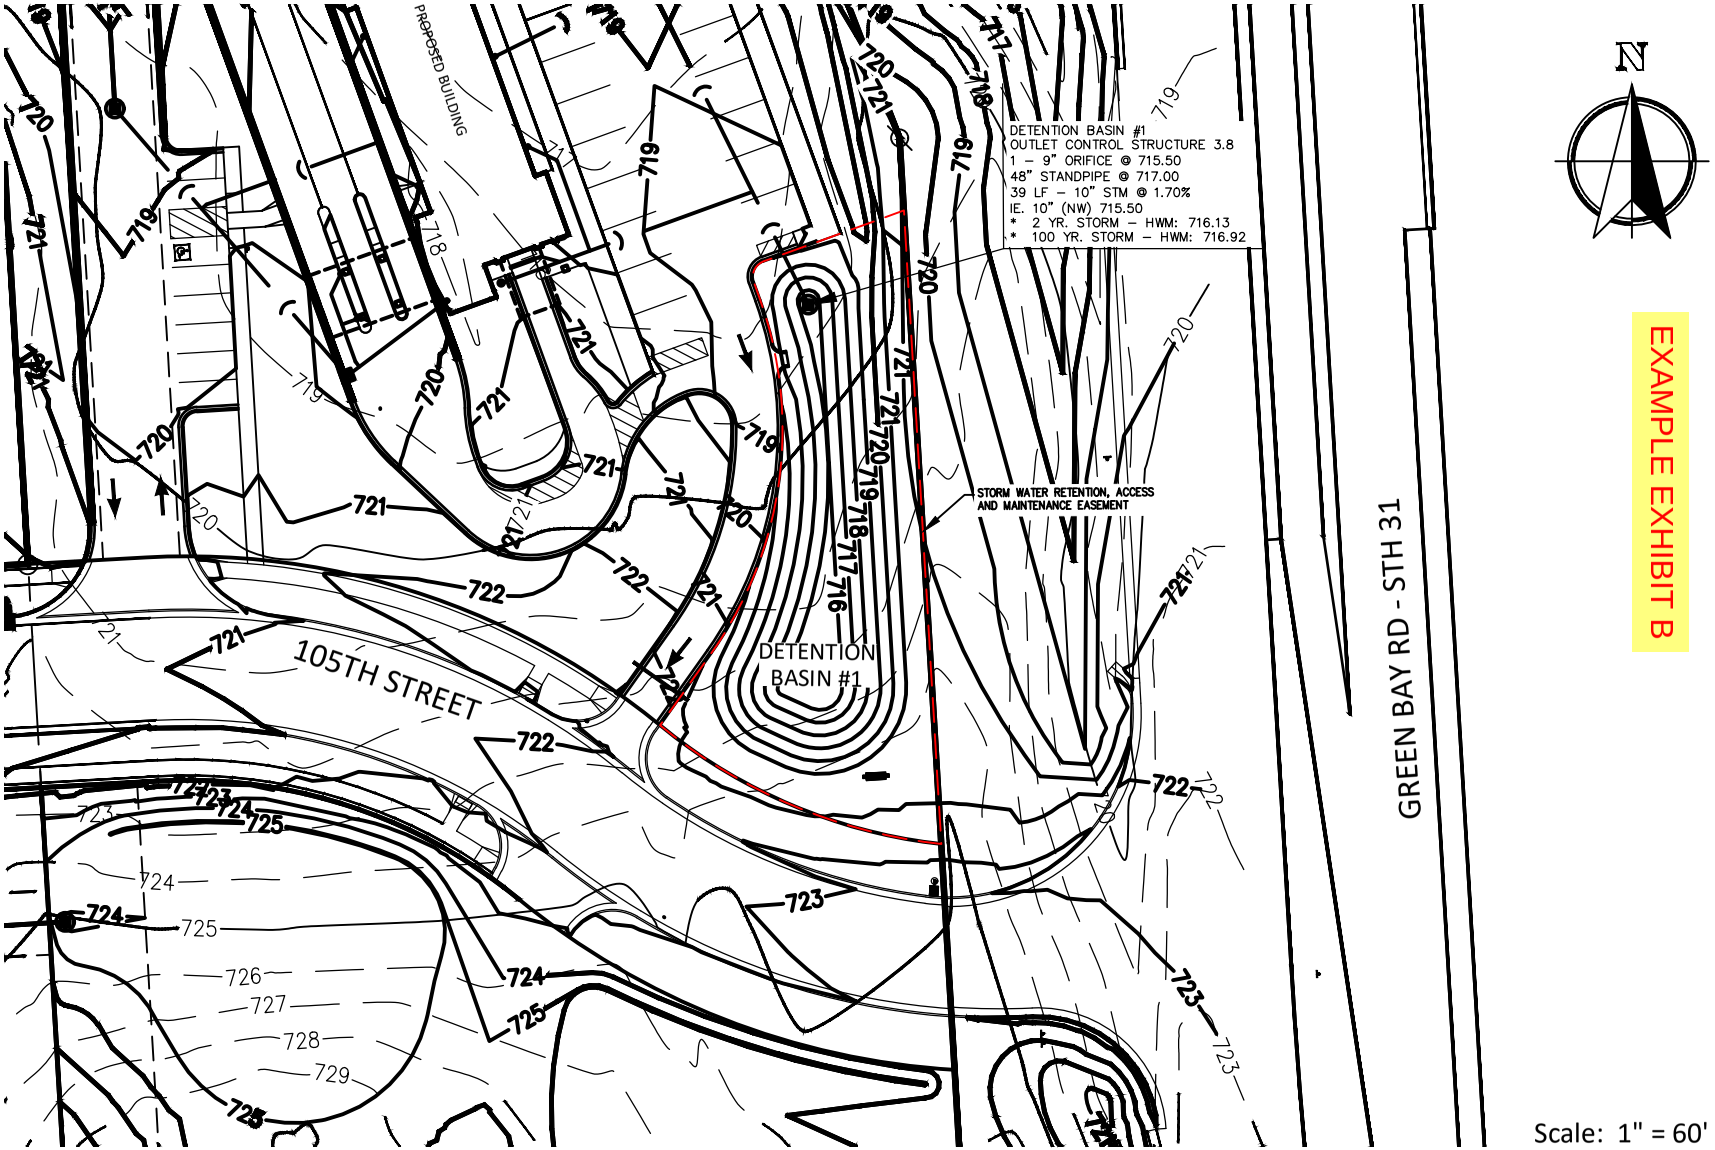


EXAMPLE EXHIBIT B

8

Nielsen Madsen + Barber
CIVIL ENGINEERS AND LAND SURVEYORS
1458 Horizon Blvd. Suite 200, Racine, WI. 53406
Tele: (262)634-5588 Website: www.nmbsc.net

Scale: 1" = 60'
Drawn By: JEM
DATE: 3-19-2026
2023.0060.01
Stormwater Maintenance Agreement - Exhibit B
Detention Basin #1
Rocket Wash
Pleasant Praire, Wisconsin

THESE PLANS AND DESIGNS ARE COPYRIGHT PROTECTED AND MAY NOT BE USED IN WHOLE OR IN PART WITHOUT THE WRITTEN CONSENT OF PINNACLE ENGINEERING GROUP, LLC

www.pinnacle-engr.com

PUBLIC WATERMAIN INFRASTRUCTURE PLANS

FOR

ZILBER INDUSTRIAL 3 @ LAKEVIEW CORPORATE PARK

108TH STREET & GREEN BAY ROAD (STH "31")

VILLAGE OF PLEASANT PRAIRIE, KENOSHA COUNTY

August 11, 2026
Village Engineer Comments

RIGHT-OF-WAY PERMIT(S). FAILURE TO COMPLETE THE WORK IN ACCORDANCE WITH THESE REQUIREMENTS MAY RESULT IN THE

LEGEND

	EXISTING	PROPOSED
SANITARY SEWER MANHOLE	S	
STORM SEWER MANHOLE	ST	
STORM SEWER CATCH BASIN (ROUND CASTING)		
FENCE POST		
STORM SEWER CATCH BASIN (RECTANGULAR CASTING)		
PRECAST FLARED END SECTION		
CONCRETE HEADWALL		
VALVE BOX	W	
FIRE HYDRANT		
CLEANOUT		
SANITARY SEWER		
FORCE MAIN		
STORM SEWER		
DRAIN TILE		
WATER MAIN	W	W
FIRE PROTECTION		FP
ELECTRICAL CABLE	E	E
OVERHEAD WIRES	OHW	OHW
GAS MAIN	G	G
TELEPHONE LINE	T	T
UTILITY CROSSING		X
CAUTION EXISTING UTILITIES NEARBY		CAUTION
GRANULAR TRENCH BACKFILL		
LIGHTING		
ELECTRICAL TRANSFORMER OR PEDESTAL	TF	
POWER POLE		
POWER POLE WITH LIGHT		
GUY WIRE		
STREET SIGN		
CONTOUR	749	749
SPOT ELEVATION	×(750.00)	✦750.00
WETLANDS	WET	
PRIMARY ENVIRONMENTAL CORRIDOR	PEC	
FLOODWAY		
FLOODPLAIN		
HIGH WATER LEVEL (HWL)		
NORMAL WATER LEVEL (NWL)		
DIRECTION OF SURFACE FLOW		
DITCH OR SWALE		
DIVERSION SWALE		
OVERFLOW RELIEF ROUTING		
TREE WITH TRUNK SIZE	6" 6"	
SOIL BORING	B-8 B-9 B-10	B-1 B-2 B-3
TOPSOIL PROBE		
FENCE LINE, TEMPORARY SILT	SF	SF
FENCE LINE, WIRE		
FENCE LINE, CHAIN LINK OR IRON		
FENCE LINE, WOOD OR PLASTIC		
CONCRETE SIDEWALK		
CURB AND GUTTER		
REVERSE PITCH CURB & GUTTER		
EASEMENT LINE		

ABBREVIATIONS

BL	BASE LINE	NWL	NORMAL WATER LEVEL
C	LONG CHORD OF CURVE	PC	POINT OF CURVATURE
C & G	CURB AND GUTTER	PT	POINT OF TANGENCY
CB	CATCH BASIN	PVI	POINT OF VERTICAL INTERSECTION
CL	CENTERLINE	R	RADIUS
D	DEGREE OF CURVE	ROW	RIGHT-OF-WAY
EP	EDGE OF PAVEMENT	SAN	SANITARY SEWER
FF	FINISHED FLOOR	ST	STORM SEWER
FG	FINISHED GRADE	T	TANGENCY OF CURVE
FL	FLOW LINE	TB	TOP OF BANK
FP	FLOODPLAIN	TC	TOP OF CURB
FR	FRAME	TF	TOP OF FOUNDATION
FW	FLOODWAY	TP	TOP OF PIPE
HWL	HIGH WATER LEVEL	TS	TOP OF SIDEWALK
INV	INVERT	TW	TOP OF WALK
INL	INLET	WM	WATER MAIN
L	LENGTH OF CURVE	△	INTERSECTION ANGLE
MH	MANHOLE		

GOVERNING AGENCY CONTACTS:

PLEASANT PRAIRIE VILLAGE HALL
9915 39TH STREET
PLEASANT PRAIRIE, WI 53158
(262) 694-1400

COMMUNITY DEVELOPMENT DEPARTMENT
ROB HANSON
DIRECTOR OF COMMUNITY DEVELOPMENT
(262) 925-6717
rhanson@pleasantprairiewi.gov

PEGGY HERRICK
ASSISTANT PLANNER & ZONING ADMINISTRATOR
(262) 925-6716
pherrick@pleasantprairiewi.gov

MIRANDA STEINMETZ
ADMINISTRATIVE COORDINATOR / PLANNER I
(262) 925-6717
msteinmetz@pleasantprairiewi.gov

ENGINEERING DEPARTMENT
MATT FINEOUR, P.E.
EXECUTIVE DIRECTOR OF INFRASTRUCTURE MANAGEMENT
(262) 925-6778
mfineour@pleasantprairiewi.gov

KURT DAVIDSEN, P.E.
VILLAGE ENGINEER
(262) 925-6728
kdavidsen@pleasantprairiewi.gov

PUBLIC WORKS DEPARTMENT
TOM HUPP
DIRECTOR OF PUBLIC WORKS
ROGER PRANGE MUNICIPAL BUILDING
8600 GREEN BAY ROAD
(262) 925-6768
thupp@pleasantprairiewi.gov

BUILDING INSPECTION DEPARTMENT
SANDRO PEREZ
BUILDING INSPECTION SUPERINTENDENT
(262) 694-9304 OFFICE
(262) 925-6722 DIRECT
sperez@pleasantprairiewi.gov

MICHAEL KAPRELIAN
BUILDING INSPECTOR
(262) 694-9304
mkaprelian@pleasantprairiewi.gov

FIRE & RESCUE DEPARTMENT
CRAIG ROEPKE,
CHIEF OF FIRE & RESCUE
8044 88TH AVENUE
(262) 694-8027
croepke@pleasantprairiewi.gov

AARON LONGRIE
ASSISTANT FIRE CHIEF
(262) 694-8027
alongrie@pleasantprairiewi.gov

WISCONSIN DOT
ART BAUMANN
TRAFFIC OPERATIONS ENGINEER
(262) 548-6707
art.baumann@dot.wi.gov

KEVIN KOEHNKE, P.E.
PERMITS COORDINATOR
(262) 548-5891
kevin.koehnke@dot.wi.gov

KENOSHA COUNTY
GREG BOLDT, P.E.
DIRECTOR/HIGHWAY COMMISSIONER
DIVISION OF HIGHWAYS - PUBLIC WORKS DEPARTMENT
OFFICE: (262) 857-1870
CELL: (262) 220-0805
gregory.boldt@kenoshacounty.org


WI DEPARTMENT OF NATURAL RESOURCES
ALISON MASEK
WATER MANAGEMENT SPECIALIST
(608) 575-9849
alison.masek@wisconsin.gov

PETER WOOD. P.E.
WATER RESOURCES ENGINEER
(262) 884-2360
peter.wood@wisconsin.gov

PLANS PREPARED FOR:

ZILBER PROPERTY GROUP SM

710 N. PLANKINGTON AVE.
MILWAUKEE, WI 53203

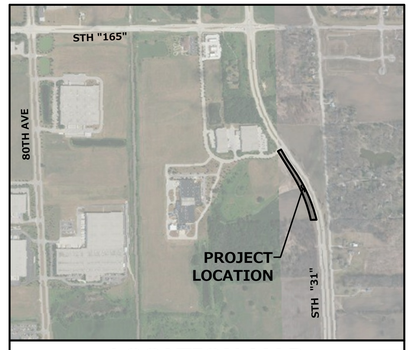

LOCATION MAP
SCALE: 1"=1000'

PROJECT TEAM CONTACTS:

CIVIL ENGINEER:
ANDY SHOAF, P.E.
PINNACLE ENGINEERING GROUP
20725 WATERTOWN ROAD, SUITE 100
BROOKFIELD, WI 53186
(262) 754-8888
andrew.shoaf@pinnacle-engr.com

APPLICANT:
JASON LUEDERS
ZILBER PROPERTY GROUP
710 N. PLANKINGTON AVENUE
MILWAUKEE, WI 53203
(414) 274-2807

SURVEYOR:
JOHN KONOPACKI
PINNACLE ENGINEERING GROUP
20725 WATERTOWN ROAD, SUITE 100
BROOKFIELD, WI 53186
(262) 754-8888
john.konopacki@pinnacle-engr.com

ARCHITECT
JEREMY HALL, A.I.A.
PARTNERS IN DESIGN
2610 LAKE COOK ROAD, SUITE 280
RIVERWOODS, IL 60015
(847) 940-0300
jeremyh@pidarchitects.com

PUBLIC UTILITY CONTACTS:

AMERICAN TRANSMISSION COMPANY
BRIAN MCGEE
(262) 506-6895
bmcgee@atcllc.com
(800) 972-5341 EMERGENCY

AT&T
BRENT LEWIS
(414) 429-4214
bl521d@att.com

TDS TELECOM
SOUTHEAST WISCONSIN
(877) 483-7142

TIME WARNER CABLE/SPECTRUM
STEVE CRAMER
CONSTRUCTION SUPERVISOR
(414) 277-4045
steve.cramer@charter.com
(800) 627-2288 EMERGENCY

WEC ENERGY GROUP
JOEL BURROW
CEM MANAGER
(414) 221-3192
joel.burrow@wecenergygroup.com

WE ENERGIES
ALLIE KLAWINSKI
SR. SERVICE MANAGER
(262) 552-3227
allie.klawinski@we-energies.com

MICHAEL BAKER
CUSTOMER SERVICE MANAGER
(262) 886-7041
michael.baker@we-energies.com

HUSSAIN BIYAWERWALA
SENIOR ENGINEER
(262) 886-7074
hussain.biyawerwala@we-energies.com

BRANDON ERTS
GAS ENGINEERING
(414) 221-3654
brandon.erts@we-energies.com

NATURAL GAS EMERGENCY
(800) 261-5325

ELECTRICAL EMERGENCY
(800) 662-4797

VILLAGE NOTES

1. PRIOR TO CONSTRUCTION, A PRE-CONSTRUCTION CONFERENCE MUST BE HELD AT THE VILLAGE OFFICES. THE PRE-CONSTRUCTION CONFERENCE SHALL BE SCHEDULED AND MODERATED BY THE DESIGNING ENGINEER OF RECORD.
2. EACH CONTRACTOR SHALL HAVE A COPY OF THE VILLAGE APPROVED PLANS, PROJECT MANUAL, AND VILLAGE CONSTRUCTION SPECIFICATIONS ON-SITE DURING TIMES OF CONSTRUCTION. THE CONSTRUCTION SPECIFICATIONS ARE AN INTEGRAL PART OF THE CIVIL ENGINEERING PLANS.
3. ALL WORK WITHIN VILLAGE RIGHTS-OF-WAY, PUBLIC EASEMENTS, OR ON VILLAGE FACILITIES SHALL BE COMPLETED IN ACCORDANCE WITH VILLAGE ORDINANCE CHAPTER 405 BY PREQUALIFIED CONTRACTORS AND IN COMPLIANCE WITH THE APPLICABLE WORK IN THE VILLAGE REQUIRING THE ASSOCIATED IMPROVEMENTS TO BE REMOVED AND REPLACED.

INDEX OF SHEETS

C-1	COVER SHEET
C-2	EXISTING CONDITIONS
C-3 - C-4	WATERMAIN PLAN & PROFILE
C-5	EROSION CONTROL PLAN
C-6 - C-8	CONSTRUCTION DETAILS

REQUIRED SUBMITTALS FOR APPROVAL

1. **HOT MIX ASPHALT** - MIX DESIGN
2. **CONCRETE PAVEMENTS (EXTERIOR)** - MIX DESIGN & JOINT PLAN
3. **PAVEMENT STONE BASE COURSE** - GRADATION
4. **PIPE BEDDING & TRENCH BACKFILL** - GRADATION

REQUIRED SUBMITTALS FOR RECORDS

1. **WATER MAIN PIPES, VALVES, HYDRANTS & FITTINGS**
2. **TRACER WIRE**
3. **UNDERGROUND UTILITY LOCATION RECORD DRAWINGS**
4. **CHEMICAL SOIL STABILIZATION MIX DESIGN (IF APPLICABLE)**

GENERAL NOTES

1. THE INTENTION OF THE PLANS AND SPECIFICATIONS IS TO SET FORTH PERFORMANCE AND CONSTRUCTION MATERIAL STANDARDS FOR THE PROPER EXECUTION OF WORK. ALL WORKS CONTAINED WITHIN THE PLANS AND SPECIFICATIONS SHALL BE COMPLETED IN ACCORDANCE WITH ALL REQUIREMENTS FROM LOCAL, STATE, FEDERAL OR OTHER GOVERNING AGENCY'S LAWS, REGULATIONS, JURISDICTIONAL ORDINANCES/CODES/RULES/ETC., AND THE OWNER'S DIRECTION.
2. A GEOTECHNICAL REPORT IS AVAILABLE AT THIS TIME FOR THE PROJECT SITE. IT SHALL BE EXPRESSLY UNDERSTOOD THAT OWNER WILL NOT BE RESPONSIBLE FOR ANY INTERPRETATIONS OR CONCLUSIONS DRAWN THERE FROM BY THE CONTRACTOR. DATA IS MADE AVAILABLE FOR THE CONVENIENCE OF THE CONTRACTOR. THE CONTRACTOR IS RESPONSIBLE FOR PERFORMING ANY ADDITIONAL SOILS INVESTIGATIONS THEY FEEL IS NECESSARY FOR THE PROPER EVALUATION OF THE SITE FOR PURPOSES OF PLANNING, BIDDING, OR CONSTRUCTING THE PROJECT AT NO ADDITIONAL COST TO THE OWNER.
3. THE CONTRACTOR IS RESPONSIBLE TO REVIEW AND UNDERSTAND ALL COMPONENTS OF THE PLANS, REPORTS, AND SPECIFICATIONS, INCLUDING FIELD VERIFYING SOIL CONDITIONS, PRIOR TO SUBMISSION OF A BID PROPOSAL.
4. THE CONTRACTOR SHALL PROMPTLY REPORT ANY ERRORS OR AMBIGUITIES LEARNED AS PART OF THEIR REVIEW OF PLANS, SPECIFICATIONS, REPORTS AND FIELD INVESTIGATIONS.
5. THE CONTRACTOR IS SOLELY RESPONSIBLE FOR THE COMPUTATION OF QUANTITIES AND WORK REQUIRED TO COMPLETE THIS PROJECT. THE CONTRACTOR'S BID SHALL BE BASED ON ITS OWN COMPUTATIONS AND IN NO SUCH INSTANCE RELY ON THE ENGINEER'S ESTIMATE.
6. QUESTIONS/CLARIFICATIONS WILL BE INTERPRETED BY ENGINEER/OWNER PRIOR TO THE AWARD OF CONTRACT. ENGINEER/OWNER WILL SUBMIT OFFICIAL RESPONSES IN WRITING. INTERPRETATIONS PRESENTED IN OFFICIAL RESPONSES SHALL BE BINDING ON ALL PARTIES ASSOCIATED WITH THE CONTRACT. IN NO WAY SHALL WORD-OF-MOUTH DIALOG CONSTITUTE AN OFFICIAL RESPONSE.
7. PRIOR TO CONSTRUCTION, A PRE-CONSTRUCTION CONFERENCE MUST BE HELD AT THE VILLAGE OFFICES. THE PRE-CONSTRUCTION CONFERENCE SHALL BE SCHEDULED AND MODERATED BY THE DESIGNING ENGINEER OF RECORD
8. PRIOR TO START OF WORK, CONTRACTOR SHALL BE COMPLETELY FAMILIAR WITH ALL CONDITIONS OF THE SITE, AND SHALL ACCOUNT FOR CONDITIONS THAT AFFECT, OR MAY AFFECT CONSTRUCTION INCLUDING, BUT NOT LIMITED TO, LIMITATIONS OF WORK ACCESS, SPACE LIMITATIONS, OVERHEAD OBSTRUCTIONS, TRAFFIC PATTERNS, LOCAL REQUIREMENTS, ADJACENT ACTIVITIES, ETC. FAILURE TO CONSIDER SITE CONDITIONS SHALL NOT BE CAUSE FOR CLAIM OF JOB EXTRAS.
9. COMMENCEMENT OF CONSTRUCTION SHALL EXPLICITLY CONFIRM THAT THE CONTRACTOR HAS REVIEWED THE PLANS AND SPECIFICATIONS IN ENTIRETY AND CERTIFIES THAT THEIR SUBMITTED BID PROPOSAL CONTAINS PROVISIONS TO COMPLETE THE PROJECT, WITH THE EXCEPTION OF UNFORESEEN FIELD CONDITIONS; ALL APPLICABLE PERMITS HAVE BEEN OBTAINED; AND CONTRACTOR UNDERSTANDS ALL OF THE REQUIREMENTS OF THE PROJECT.
10. SHOULD ANY DISCREPANCIES OR CONFLICTS IN THE PLANS OR SPECIFICATIONS BE DISCOVERED AFTER THE AWARD OF CONTRACT, ENGINEER SHALL BE NOTIFIED IN WRITING IMMEDIATELY AND CONSTRUCTION OF ITEMS AFFECTED BY THE DISCREPANCIES/CONFLICTS SHALL NOT COMMENCE, OR CONTINUE, UNTIL A WRITTEN RESPONSE FROM ENGINEER/OWNER IS DISTRIBUTED. IN THE EVENT OF A CONFLICT BETWEEN REFERENCED CODES, STANDARDS, SPECIFICATIONS AND PLANS, THE ONE ESTABLISHING THE MOST STRINGENT REQUIREMENTS SHALL BE FOLLOWED.
11. THE CONTRACTOR SHALL, AT ITS OWN EXPENSE, OBTAIN ALL NECESSARY PERMITS AND LICENSES TO COMPLETE THE PROJECT, OBTAINING PERMITS, OR DELAYS, IS NOT CAUSE FOR DELAY OF THE CONTRACT OR SCHEDULE. CONTRACTOR SHALL COMPLY WITH ALL PERMIT REQUIREMENTS.
12. THE CONTRACTOR SHALL NOTIFY ALL INTERESTED GOVERNING AGENCIES. UTILITY COMPANIES AFFECTED BY THIS CONSTRUCTION PROJECT, AND DIGGER'S HOTLINE IN ADVANCE OF CONSTRUCTION TO COMPLY WITH ALL JURISDICTIONAL ORDINANCES/CODES/RULES/ETC., PERMIT STIPULATIONS, AND OTHER APPLICABLE STANDARDS.
13. SAFETY IS THE SOLE RESPONSIBILITY OF THE CONTRACTOR. THE CONTRACTOR SHALL BE RESPONSIBLE TO INITIATE, INSTITUTE, ENFORCE, MAINTAIN, AND SUPERVISE ALL SAFETY PRECAUTIONS AND JOB SITE SAFETY PROGRAMS IN CONNECTION WITH THE WORK.
14. CONTRACTOR SHALL KEEP THE JOBSITE CLEAN AND ORDERLY AT ALL TIMES. ALL LOCATIONS OF THE SITE SHALL BE KEPT IN A WORKING MANNER SUCH THAT DEBRIS IS REMOVED CONTINUOUSLY AND ALL RESPECTIVE CONTRACTORS OPERATE UNDER GENERAL "GOOD HOUSEKEEPING."
15. THE CONTRACTOR SHALL INDEMNIFY THE OWNER, ENGINEER, AND THEIR AGENTS FROM ALL LIABILITY INVOLVED WITH THE CONSTRUCTION, INSTALLATION, AND TESTING OF THE WORK ON THIS PROJECT.
16. ANY WATER SHUTDOWNS NEEDED DURING CONSTRUCTION WILL NEED TO BE PERFORMED BY THE VILLAGE OF PLEASANT PRAIRIE DEPARTMENT OF PUBLIC WORKS AND COORDINATED WITH AREA BUSINESSES.

DIGGERS HOTLINE
Toll Free (800) 242-8511
Milwaukee Area (414) 259-1181
Hearing Impaired TDD (800) 542-2289
www.DiggersHotline.com

EXPIRATION DATE: JULY 31, 2020

PINNACLE ENGINEERING GROUP, LLC - ENGINEER'S LIMITATION

PINNACLE ENGINEERING GROUP, LLC AND THEIR CONSULTANTS DO NOT WARRANT OR GUARANTEE THE ACCURACY AND COMPLETENESS OF THE DELIVERABLES HEREIN BEYOND A REASONABLE DILIGENCE. IF ANY MISTAKES, OMISSIONS, OR DISCREPANCIES ARE FOUND TO EXIST WITHIN THE DELIVERABLES, THE ENGINEER SHALL BE PROMPTLY NOTIFIED PRIOR TO BID SO THAT HE MAY HAVE THE OPPORTUNITY TO TAKE WHATEVER STEPS NECESSARY TO RESOLVE THEM. FAILURE TO PROMPTLY NOTIFY THE ENGINEER OF SUCH CONDITIONS SHALL ABSOLVE THE ENGINEER FROM ANY RESPONSIBILITY FOR THE CONSEQUENCES OF SUCH FAILURE. ACTIONS TAKEN WITHOUT THE KNOWLEDGE AND CONSENT TO THE ENGINEER, OR IN CONTRADICTION TO THE ENGINEER'S DELIVERABLES OR RECOMMENDATIONS, SHALL BECOME THE RESPONSIBILITY NOT OF THE ENGINEER BUT OF THE PARTIES RESPONSIBLE FOR TAKING SUCH ACTION.

FURTHERMORE, PINNACLE ENGINEERING GROUP, LLC IS NOT RESPONSIBLE FOR CONSTRUCTION SAFETY OR THE MEANS AND METHODS OF CONSTRUCTION.

REVIEWED:
DESIGNED: AJS
DRAFTED: AJS

PLAN | DESIGN | DELIVER
www.pinnacle-engr.com

PINNACLE ENGINEERING GROUP
ENGINEERING | NATURAL RESOURCES | SURVEYING

WISCONSIN OFFICE:
20725 WATERTOWN ROAD, SUITE 100
BROOKFIELD, WI 53186
(262) 754-8888
CHICAGO | MILWAUKEE · NATIONWIDE

ZILBER INDUSTRIAL 3 @ LAKEVIEW CORPORATE PARK
108TH STREET & GREEN BAY ROAD (STH "31")
VILLAGE OF PLEASANT PRAIRIE, KENOSHA COUNTY

COVER SHEET

REVISIONS

1	VOPP SUBMITTAL	05/21/26			
2	VOPP RESUBMITTAL	07/17/26			

PEG JOB No. 644.00-WI
PEG PM AJS
START DATE 03/20/26
SCALE N.T.S.

SHEET
C-1
C-8

©COPYRIGHT 2019

COVER SHEET

Z:\PROJECTS\2016\644.00-WI\CAD\SHEETS\WATERMAIN PLAN SHEETS\644.00-WI-SHEETS-COVER.DWG

THESE PLANS AND DESIGNS ARE COPYRIGHT PROTECTED AND MAY NOT BE USED IN WHOLE OR IN PART WITHOUT THE WRITTEN CONSENT OF PINNACLE ENGINEERING GROUP, LLC

CONTRACTOR SHALL VERIFY LOCATION AND ELEVATION OF ALL EXISTING UTILITIES PRIOR TO INSTALLATION OF PROPOSED UTILITIES.

ALL WORK WITHIN PUBLIC R.O.W. AND PUBLIC EASEMENTS SHALL CONFORM TO THE VILLAGE OF PLEASANT PRAIRIE CHAPTER 405 CONSTRUCTION SPECIFICATIONS.

PUBLIC WORKS COORDINATION

1. CONTRACTOR SHALL COORDINATE AND SCHEDULE INSPECTIONS FOR ALL WORK ON PUBLIC IMPROVEMENTS WITH THE ENGINEERING DEPARTMENT. WORK WITHIN PUBLIC EASEMENTS OR RIGHT OF WAY SHALL NOT COMMENCE UNTIL ENGINEERING DEPARTMENT HAS BEEN CONTACTED AND INSPECTOR IS ON SITE.
2. ALL PUBLIC WATER VALVES SHALL BE OPERATED BY OR UNDER THE SUPERVISION OF THE PUBLIC WORKS DEPARTMENT. CONTRACTOR SHALL COORDINATE WITH THE PUBLIC WORKS DEPARTMENT.

EXISTING CONDITIONS SURVEY:

EXISTING CONDITIONS SURVEY PROVIDED BY PINNACLE ENGINEERING GROUP. ALTHOUGH PEG HAS NO REASON TO BELIEVE THE SURVEY IS INACCURATE, PEG MAKES NO WARRANTS THAT EXISTING INFORMATION CONTAINED WITHIN THESE PLANS IS ALL-INCLUSIVE OR ACCURATE. CONTRACTOR SHALL UNDERTAKE NECESSARY EFFORTS TO VERIFY THE EXISTING CONDITIONS PRIOR TO THE START OF MATERIAL PROCUREMENT AND CONSTRUCTION EFFORTS/ACTIVITIES.

NORTH

GRAPHICAL SCALE (FEET)


0 1" = 20' 40'


LEGEND

- SANITARY SEWER MANHOLE
- STORM SEWER MANHOLE
- STORM SEWER CATCH BASIN (ROUND CASTING)
- STORM SEWER CATCH BASIN (RECTANGULAR CASTING)
- PRECAST CONCRETE FLARED END SECTION
- VALVE BOX
- FIRE HYDRANT
- SANITARY SEWER
- STORM SEWER
- DRAIN TILE (SEE DETAIL)
- DRAIN TILE DONUT (SEE DETAIL)
- W WATER MAIN
- FP FIRE PROTECTION
- UTILITY CROSSING
- PROPOSED ELECTRICAL CABLE (APPROXIMATE LOCATION)
- PROPOSED GAS MAIN (APPROXIMATE LOCATION)
- TELEPHONE LINE
- OHW OVERHEAD WIRES
- LIGHTING
- ELECTRICAL TRANSFORMER OR PEDESTAL
- POWER POLE
- POWER POLE WITH LIGHTS
- STREET SIGN
- REMOVE EXISTING UTILITY

PROVIDE DRAFT PROJECT MANUAL/CONTRACT FOR PUBLIC WATER MAIN IMPROVEMENTS FOR REVIEW. CREATE SOMETHING SIMILAR TO THAT USED FOR CEDAR RIDGE SUBDIVISION (TONY ZANON IS THE ENGINEER) FOR THE MANUAL/CONTRACT. PROVIDE THE VILLAGE THE DRAFT DNR WATER MAIN EXTENSION SUBMITTAL FOR REVIEW. THE VILLAGE WILL SUBMIT THE WATER MAIN EXTENSION TO KWU FOR THEIR REVIEW. UPON APPROVAL OF THE WATER MAIN EXTENSION, DEVELOPER OR ENGINEER MUST SUBMIT FOR THE WATER MAIN EXTENSION WITH THE DNR.

CONTRACTS WILL BE NEEDED TO EXECUTED FOR THE FINANCIAL SECURITY.

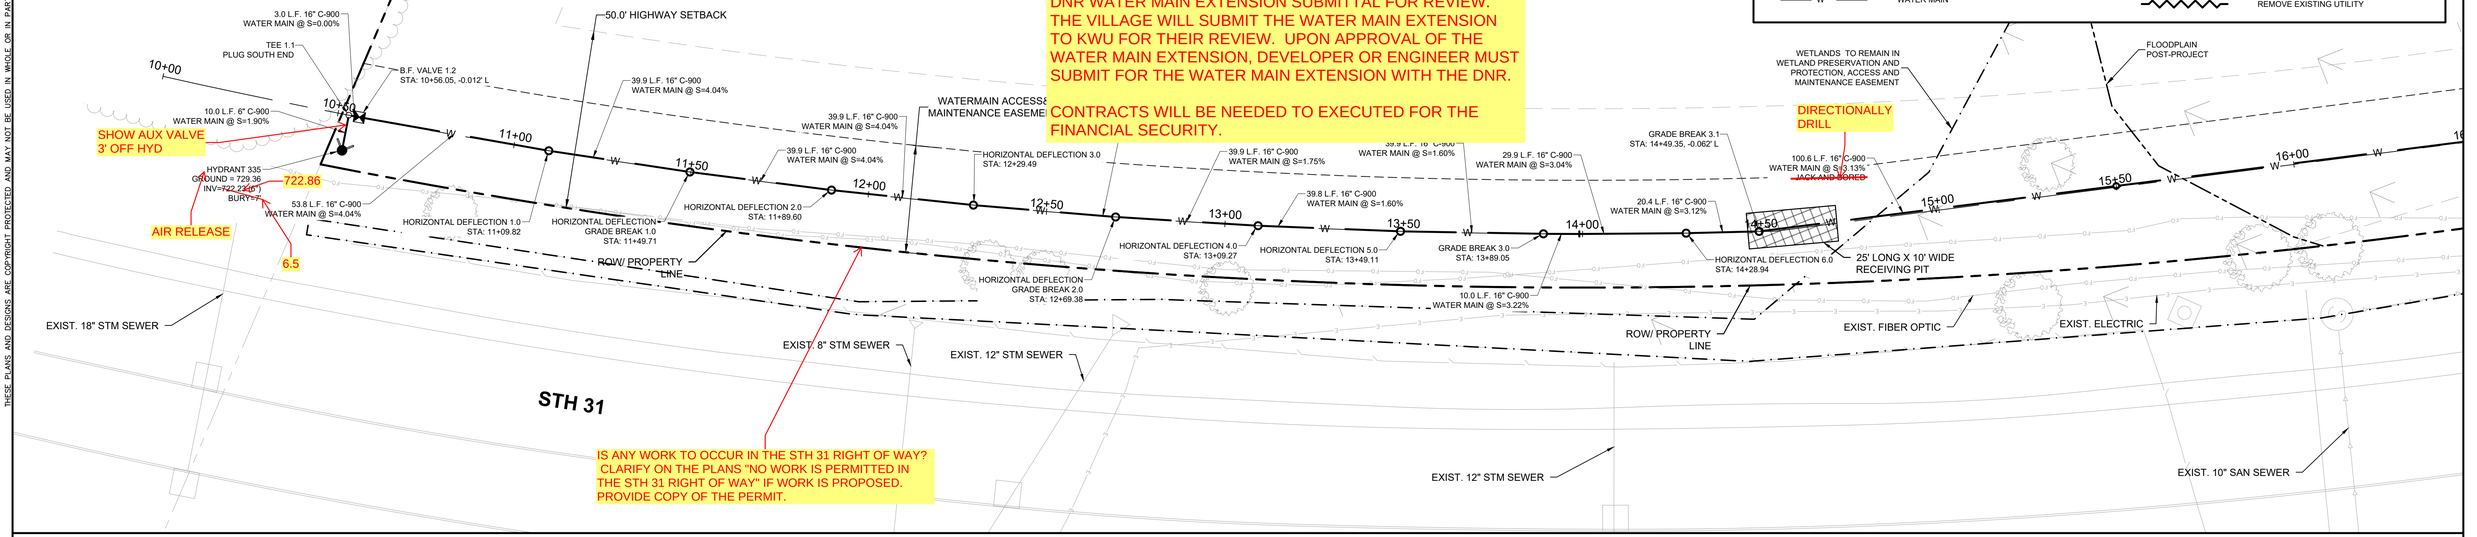

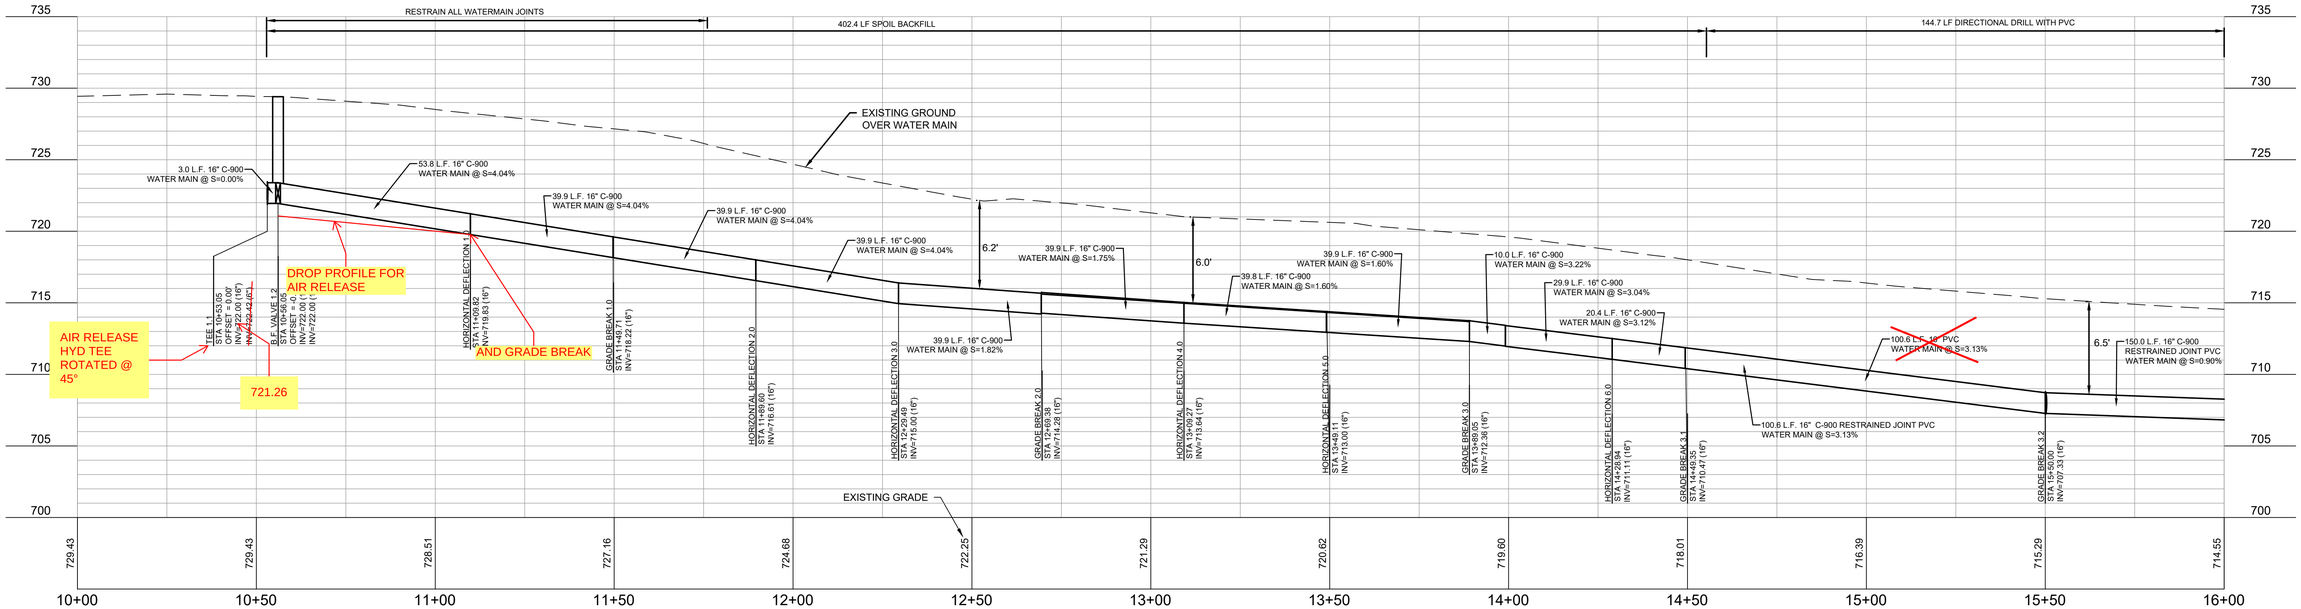

REVIEWED:
DESIGNED: AJS
DRAFTED: AJS

PLAN | DESIGN | DELIVER
www.pinnacle-engr.com

PINNACLE ENGINEERING GROUP
ENGINEERING | NATURAL RESOURCES | SURVEYING

WISCONSIN OFFICE:
20725 WATERTOWN ROAD, SUITE 100
BROOKFIELD, WI 53186
(262) 754-8888
CHICAGO | MILWAUKEE : NATIONWIDE

ZILBER INDUSTRIAL 3 @ LAKEVIEW CORPORATE PARK

108TH STREET & GREEN BAY ROAD (STH "31")
VILLAGE OF PLEASANT PRAIRIE, KENOSHA COUNTY

WATERMAIN PLAN & PROFILE

REVISIONS

1	VOPP SUBMITTAL	05/21/26	
2	VOPP RESUBMITTAL	07/17/26	

PEG JOB No. 644.00-WI
PEG PM AJS
START DATE 03/20/26
SCALE

SHEET
C-3
C-8

© COPYRIGHT 2019

WATERMAIN PLAN & PROFILE

www.pinnacle-engr.com

Z:\PROJECTS\2016\644.00-WI\CAD\SHEETS\WATERMAIN PLAN SHEETS\644.00-WI-SHEETS-UTILITY WATERMAIN.DWG

THESE PLANS AND DESIGNS ARE COPYRIGHT PROTECTED AND MAY NOT BE USED IN WHOLE OR IN PART WITHOUT THE WRITTEN CONSENT OF PINNACLE ENGINEERING GROUP, LLC

LEGEND

- STORM SEWER MANHOLE
- STORM STORM CATCH BASIN (ROUND CASTING)
- STORM SEWER CATCH BASIN (RECTANGULAR CASTING)
- PRECAST FLARED END SECTION
- PROPOSED CONTOUR
- WETLANDS
- FLOODPLAIN
- NORMAL WATER LEVEL (NWL)
- SF — SILT FENCE
- ORANGE SAFETY FENCE
- INLET PROTECTION (TYPE B)
- INLET PROTECTION (TYPE C)
- MEDIUM RIP RAP
- STRAW WADDLE
- CULVERT CHECK
- HYDROSEED (PER MANUFACTURER SPECIFICATIONS)
- EROSION CONTROL BLANKET (NORTH AMERICAN GREEN S75 OR EQUAL)
- TURF REINFORCEMENT MAT (NORTH AMERICAN GREEN TMAX OR EQUAL)

ALL WORK WITHIN PUBLIC R.O.W. AND PUBLIC EASEMENTS SHALL CONFORM TO THE VILLAGE OF PLEASANT PRAIRIE STANDARDS.

EXISTING CONDITIONS SURVEY:

EXISTING CONDITIONS SURVEY PROVIDED BY PINNACLE ENGINEERING GROUP. ALTHOUGH PEG HAS NO REASON TO BELIEVE THE SURVEY IS INACCURATE, PEG MAKES NO WARRANTS THAT EXISTING INFORMATION CONTAINED WITHIN THESE PLANS IS ALL-INCLUSIVE OR ACCURATE. CONTRACTOR SHALL UNDERTAKE NECESSARY EFFORTS TO VERIFY THE EXISTING CONDITIONS PRIOR TO THE START OF MATERIAL PROCUREMENT AND CONSTRUCTION EFFORTS/ACTIVITIES.

PROPOSED BUILDING
34 S.F. | F.F.E.=717.50
EE ARCHITECTURAL PLANS)

NORTH

GRAPHICAL SCALE (FEET)
0 1" = 40' 80'

108th STREET

100 YEAR FLOODPLAIN PER FEMA

WETLANDS TO REMAIN IN WETLAND PRESERVATION AND PROTECTION, ACCESS AND MAINTENANCE EASEMENT

HOW IS WATER MAIN TO BE ACCESSED ON THE SOUTH SIDE OF THE WETLAND? CLARIFY ON THE PLANS.

25' LONG X 10' WIDE RECEIVING PIT

50' x 500' VISION CORNER EASEMENT PER C.S.M. NO. 2273

25' LONG X 10' WIDE RECEIVING PIT

50' HIGHWAY SETBACK PER C.S.M. NO. 2273

TRACKING PAD LOCATION?

WETLANDS TO REMAIN IN WETLAND PRESERVATION AND PROTECTION, ACCESS AND MAINTENANCE EASEMENT

50' HIGHWAY SETBACK PER C.S.M. NO. 2273

ADD NOTE "NO WORK WITHIN THE WISDOT RIGHT OF WAY" UNLESS YOU WILL BE REQUESTING APPROVAL FROM WISDOT.

STATE TRUNK HIGHWAY "31"

www.pinnacle-engr.com

REVIEWED:
DESIGNED: AJS
DRAFTED: AJS

PLAN | DESIGN | DELIVER
www.pinnacle-engr.com

PINNACLE ENGINEERING GROUP
ENGINEERING | NATURAL RESOURCES | SURVEYING

WISCONSIN OFFICE:
20725 WATERTOWN ROAD, SUITE 100
BROOKFIELD, WI 53186
(262) 754-8888
CHICAGO | MILWAUKEE : NATIONWIDE

ZILBER INDUSTRIAL 3 @ LAKEVIEW CORPORATE PARK

108TH STREET & GREEN BAY ROAD (STH "31")
VILLAGE OF PLEASANT PRAIRIE, KENOSHA COUNTY

EROSION CONTROL PLAN

REVISIONS

1	VOPP SUBMITTAL	05/21/26	
2	VOPP RESUBMITTAL	07/17/26	

PEG JOB No. 644.00-WI
PEG PM AJS
START DATE 03/20/26
SCALE

SHEET
C-5
C-8

© COPYRIGHT 2019


EROSION CONTROL PLAN

Z:\PROJECTS\2016\644.00-WI\CAD\SHEETS\WATERMAIN PLAN SHEETS\644.00-WI-SHEETS-EROSION CONTROL.DWG


THESE PLANS AND DESIGNS ARE COPYRIGHT PROTECTED AND MAY NOT BE USED IN WHOLE OR IN PART WITHOUT THE WRITTEN CONSENT OF PINNACLE ENGINEERING GROUP, LLC

www.pinnacle-engr.com

NOTES:
1. DAMAGED CURB / GUTTER SECTIONS SHALL BE REMOVED TO THE NEAREST JOINT.
2. CURB AND GUTTER CONSTRUCTED ADJACENT TO EXISTING CURB AND GUTTER SHALL BE INSTALLED USING TWO (2) NO.4 (1/2-INCH), 18-INCH LONG TIE BARS, EVENLY SPACED, DRIVEN 9-INCHES INTO THE EXISTING CURB AND GUTTER.
3. WHERE ADJACENT PAVEMENT SECTION CONTAINS CONCRETE THE GUTTER THICKNESS SHALL EXTEND TO THE BOTTOM OF THE ADJACENT CONCRETE PAVEMENT. CURB AND GUTTER SHALL BE TIED INTO ADJACENT COMPOSITE PAVEMENT WITH #4 X 2'0" LONG TIE BARS AT 3' SPACING.

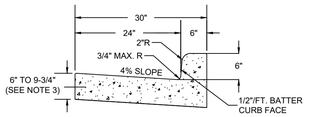


30" VERTICAL FACE CURB AND GUTTER

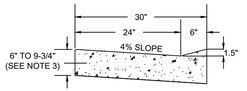

30" DEPRESSED CURB AND GUTTER AT DRIVEWAYS

30" MOUNTABLE CURB AND GUTTER

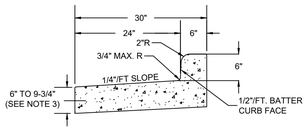


30" VERTICAL FACE CURB AND GUTTER (REVERSE SLOPE GUTTER)

SCALE: NTS

STANDARD CURB & GUTTER DETAILS


DETAIL: RD - 9	VILLAGE OF PLEASANT PRAIRIE
DATE: 6-5-20	KENOSHA COUNTY, WISCONSIN

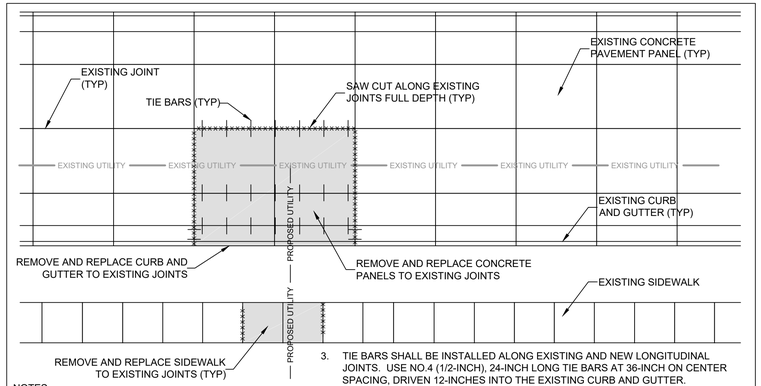

NOTES:
1. ANY PAVEMENT, CURB AND GUTTER OR SIDEWALK DAMAGED OR UNDERMINED SHALL BE REMOVED AND REPLACED TO THE NEAREST JOINT.
2. CURB AND GUTTER SHALL BE INSTALLED USING TWO (2) NO.4 (1/2-INCH), 18-INCH LONG TIE BARS, EVENLY SPACED, DRIVEN 9-INCHES INTO THE EXISTING CURB AND GUTTER.
3. TIE BARS SHALL BE INSTALLED ALONG EXISTING AND NEW LONGITUDINAL JOINTS. USE NO.4 (1/2-INCH), 24-INCH LONG TIE BARS AT 36-INCH ON CENTER SPACING, DRIVEN 12-INCHES INTO THE EXISTING CURB AND GUTTER.
4. EXISTING CONCRETE ROADWAY PAVEMENT SHALL BE REPLACED IN KIND OR WITH A MINIMUM OF 8-INCHES OF BASE AGGREGATE DENSE AND 8-INCHES OF CONCRETE PAVEMENT, WHICHEVER IS GREATER.
5. EXISTING COMPOSITE ROADWAY PAVEMENT SHALL BE REPLACED IN KIND OR WITH A MINIMUM OF 8-INCHES OF BASE AGGREGATE DENSE, 7-INCHES OF CONCRETE PAVEMENT (8-INCHES ON INDUSTRIAL ROAD AND COLLECTORS), AND 1.75-INCHES OF ASPHALTIC CONCRETE SURFACE, WHICHEVER IS GREATER.
6. REFER TO VILLAGE SPECIFICATIONS FOR ADDITIONAL REQUIREMENTS.

UTILITY PATCH DETAIL (COMPOSITE AND CONCRETE ROADWAYS)

DETAIL: RD - 15	VILLAGE OF PLEASANT PRAIRIE
DATE: 12-17-18	KENOSHA COUNTY, WISCONSIN

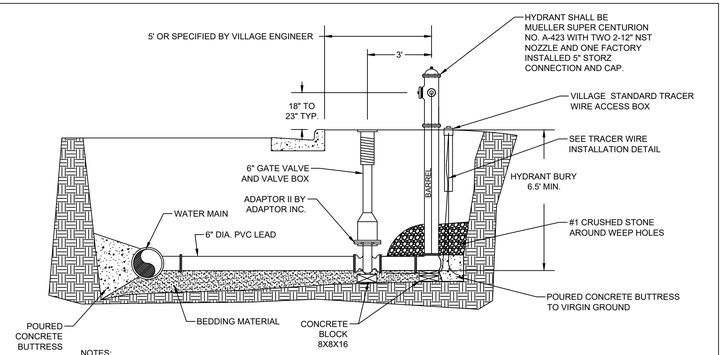

NOTES:
1. MECHANICAL JOINTS FROM TEE TO VALVE AND FROM VALVE TO HYDRANT SHALL BE RESTRAINED WITH MEGALUGS AND STAINLESS STEEL BOLTS.
2. ALL FASTENERS SHALL BE STAINLESS STEEL.
3. HYDRANT EXTENSIONS ARE NOT PERMITTED
4. ALL HYDRANTS, EXCLUDING STORZ CONNECTION, SHALL BE FACTORY PAINTED WITH EPOXY AS IDENTIFIED BELOW:
   A. PUBLIC (VILLAGE) HYDRANTS SHALL BE MUELLER RED - SHERWIN WILLIAMS POLANE F63RL15
   B. PRIVATE HYDRANTS ON VILLAGE SYSTEM PRESSURE SHALL BE CAUTION BLUE - SHERWIN WILLIAMS POLANE F63RXL9667
   C. PRIVATE PRESSURED HYDRANTS ON FIRE LOOPS SHALL BE MUELLER YELLOW - SHERWIN WILLIAMS POLANE F63YL14
5. REFER TO VILLAGE STANDARD SPECIFICATIONS FOR WATER MAIN CONSTRUCTION


SCALE: NTS

STANDARD HYDRANT ASSEMBLY

DETAIL: W - 1

DATE: 8-19-19	VILLAGE OF PLEASANT PRAIRIE
APPROVED BY: MATT FINEOUR	KENOSHA COUNTY, WISCONSIN


NOTES
1. REFER TO VILLAGE STANDARD SPECIFICATIONS FOR TRACER WIRE.

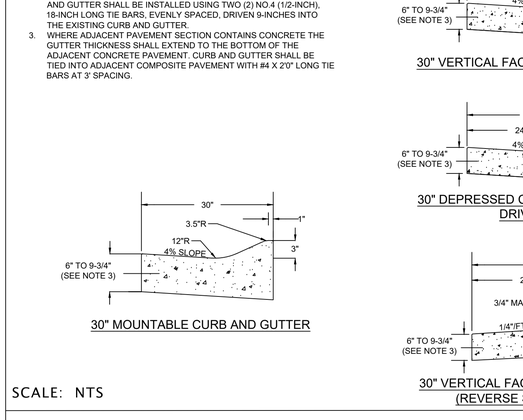

SCALE: NTS

TRACER WIRE ACCESS BOX

DETAIL: TW - 1	VILLAGE OF PLEASANT PRAIRIE
DATE: 2-4-2025	KENOSHA COUNTY, WISCONSIN

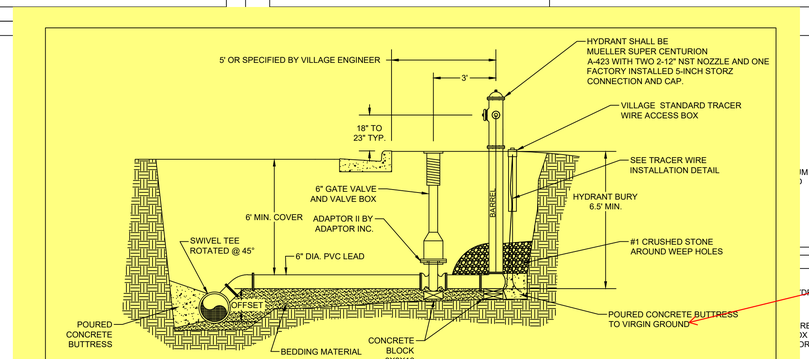

MAIN DIA (IN.)	OFFSET (FT.)
16	1.6±
18	1.7±
20	1.9±
24	2.2±

NOTES:
1. MECHANICAL JOINTS FROM TEE TO VALVE AND FROM VALVE TO HYDRANT SHALL BE RESTRAINED WITH MEGALUGS AND STAINLESS STEEL BOLTS.
2. ALL FASTENERS SHALL BE STAINLESS STEEL.
3. HYDRANT EXTENSIONS ARE NOT PERMITTED.
4. ALL HYDRANTS, EXCLUDING STORZ CONNECTION, SHALL BE FACTOR PAINTED WITH EPOXY AS IDENTIFIED BELOW:
   A. PUBLIC (VILLAGE) HYDRANTS SHALL BE MUELLER RED - SHERWIN WILLIAMS POLANE F63RL15.
   B. PRIVATE HYDRANTS ON VILLAGE SYSTEM PRESSURE SHALL BE CAUTION BLUE - SHERWIN WILLIAMS POLANE F63RXL9667.
   C. PRIVATE PRESSURIZED HYDRANTS ON FIRE LOOPS SHALL BE MUELLER YELLOW - SHERWIN WILLIAMS POLANE F63YL14.
5. REFER TO VILLAGE STANDARD SPECIFICATIONS FOR WATER MAIN CONSTRUCTION.

SCALE: NTS


AIR RELEASE HYDRANT ASSEMBLY

DETAIL: W - 2	VILLAGE OF PLEASANT PRAIRIE
DATE: 8-22-19	KENOSHA COUNTY, WISCONSIN

1. REFER TO SPECIFICATIONS FOR TRACER WIRE.
2. CONNECT TO EXISTING TRACER WIRE AT ONLY ONE LOCATION UNLESS OTHERWISE DIRECTED BY THE VILLAGE.
3. TRACER WIRE SHALL BE TAPED TO MAIN AND SERVICES. WIRE IS SHOWN OFF PIPES FOR CLARITY.
4. TAKE CARE TO PREVENT LOOPS IN TRACER WIRE. LOOPING OF WIRE CAN MAKE THE WIRE DIFFICULT TO TRACE.

TRACER WIRE INSTALLATION ON WATER MAIN

DETAIL: TW - 3	VILLAGE OF PLEASANT PRAIRIE
DATE: 12-17-18	KENOSHA COUNTY, WISCONSIN

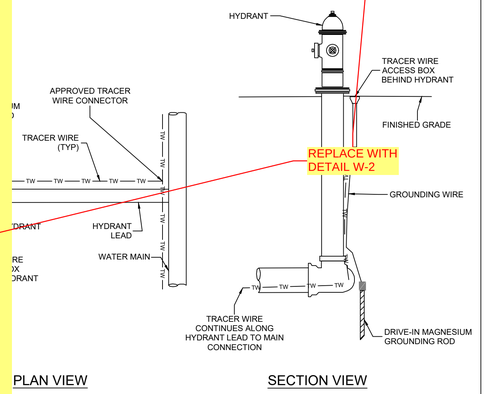


PLAN VIEW SECTION VIEW

FICATIONS FOR TRACER WIRE.
HALL BE TAPED TO MAIN, LEAD AND HYDRANT. WIRE IS SHOWN OFF PIPES FOR CLARITY.
3. INSTALL GROUNDING ANODE BY DRIVING INTO VIRGIN GROUND AT THE HYDRANT SHOE.
4. TRACER WIRE ACCESS BOX SHALL BE INSTALLED DIRECTLY BEHIND ALL FIRE HYDRANTS.

TRACER WIRE INSTALLATION ON FIRE HYDRANT

DETAIL: TW - 4	VILLAGE OF PLEASANT PRAIRIE
DATE: 12-17-18	KENOSHA COUNTY, WISCONSIN

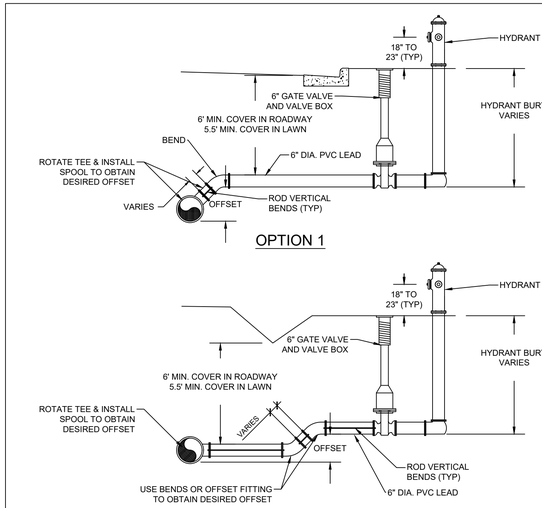

NOTES:
1. HYDRANT ASSEMBLY INSTALLATION SHALL BE IN ACCORDANCE WITH THE STANDARD HYDRANT ASSEMBLY DETAIL.
2. REFER TO THE VILLAGE STANDARD SPECIFICATIONS FOR WATER MAIN CONSTRUCTION.
3. ALL VERTICAL BENDS SHALL BE RODDED WITH STAINLESS STEEL HARDWARE.

SCALE: NTS

HYDRANT OFFSETS

DETAIL: W - 6

DATE: 8-4-16	VILLAGE OF PLEASANT PRAIRIE
APPROVED BY: MATT FINEOUR	KENOSHA COUNTY, WISCONSIN

REVIEWED:
DESIGNED: AJS
DRAFTED: AJS

PLAN I DESIGN I DELIVER
www.pinnacle-engr.com
PINNACLE ENGINEERING GROUP
ENGINEERING I NATURAL RESOURCES I SURVEYING
WISCONSIN OFFICE:
20725 WATERTOWN ROAD, SUITE 100
BROOKFIELD, WI 53186
(262) 754-8888
CHICAGO I MILWAUKEE I NATIONWIDE

ZILBER INDUSTRIAL 3 @ LAKEVIEW CORPORATE PARK

108TH STREET & GREEN BAY ROAD (STH "31")
VILLAGE OF PLEASANT PRAIRIE, KENOSHA COUNTY

CONSTRUCTION DETAILS

REVISIONS

1	VOPP SUBMITTAL	05/21/26			
2	VOPP RESUBMITTAL	07/17/26			

PEG JOB No. 644.00-WI | AJS
PEG PM | START DATE 03/20/26 | SCALE N.T.S.

SHEET C-7 C-8

© COPYRIGHT 2019

CONSTRUCTION DETAILS

Z:\PROJECTS\2016\644.00-WI\CAD\SHEETS\WATERMAIN PLAN SHEETS\644.00-WI-SHEETS-CONSTRUCTION DETAILS.DWG